


700 - 750 International Pkwy | Richardson, TX 75081



- Built in 1980
- 12'-14' Clear Height
- Rear loading with Grade Level Doors
- Easy access to Central Expressway, I-635 & George Bush Turnpike

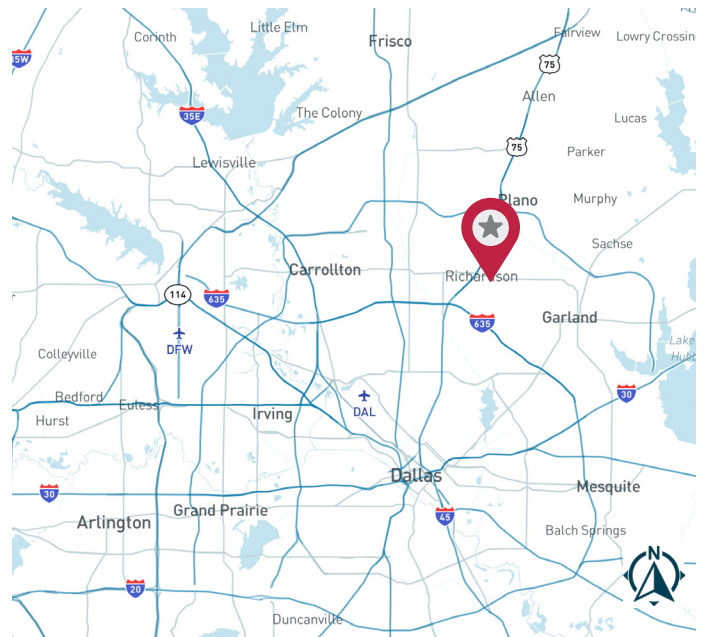

CIP REAL ESTATE




FOR LEASE

COUNTERPOINT BUSINESS CENTER


FLOOR PLAN | CURRENT AS-BUILT PLAN

STE 700-104

13,636 SF

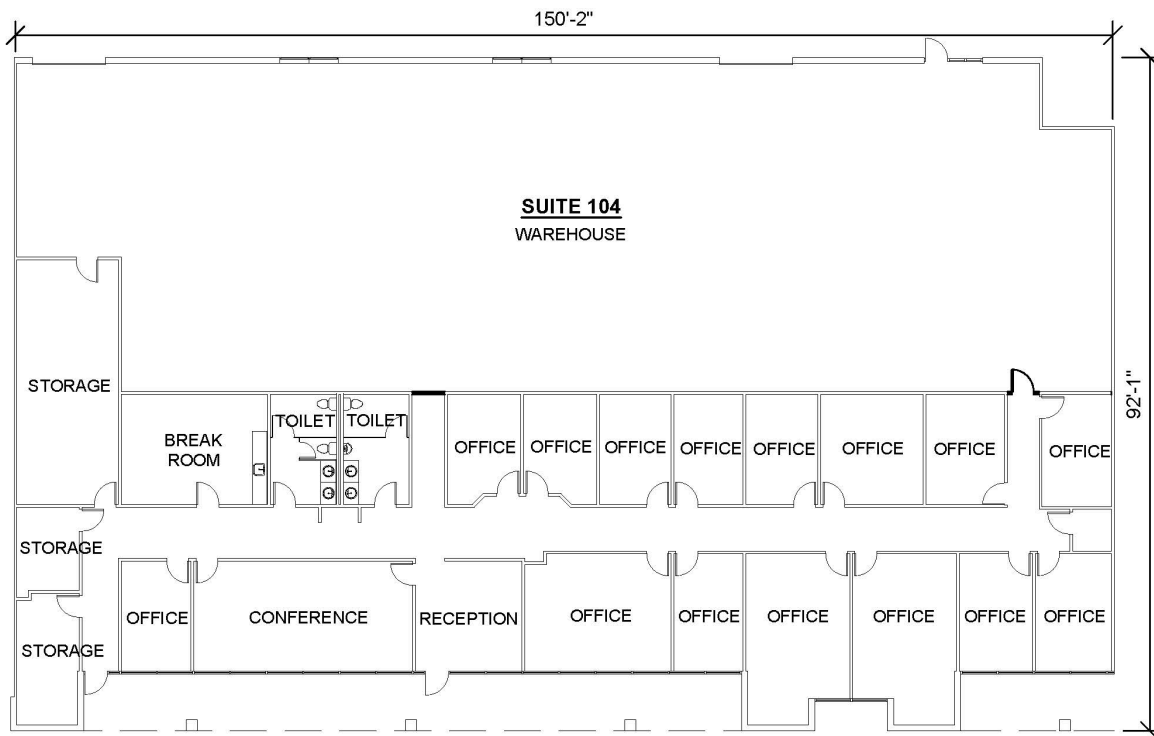

SITE PLAN

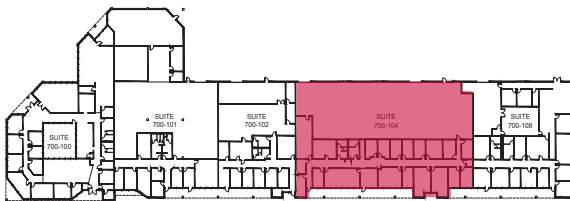

AERIAL



All information furnished regarding property for sale, rental or financing is from sources deemed reliable, but no warranty or representation is made to the accuracy thereof and same is submitted to errors, omissions, change of price, rental or other conditions prior to sale, lease or financing or withdrawal without notice. No liability of any kind is to be imposed on the broker herein.

FOR MORE INFORMATION:

JESSICA REINHARDT

972.934.4005

jreinhardt@lee-associates.com

SUSAN CANCEMI

972.934.4005


scancemi@lee-associates.com

MANAGED BY:




FLOOR PLAN | CONCEPTUAL DEMISING PLAN


STE 700-104
4,942 SF

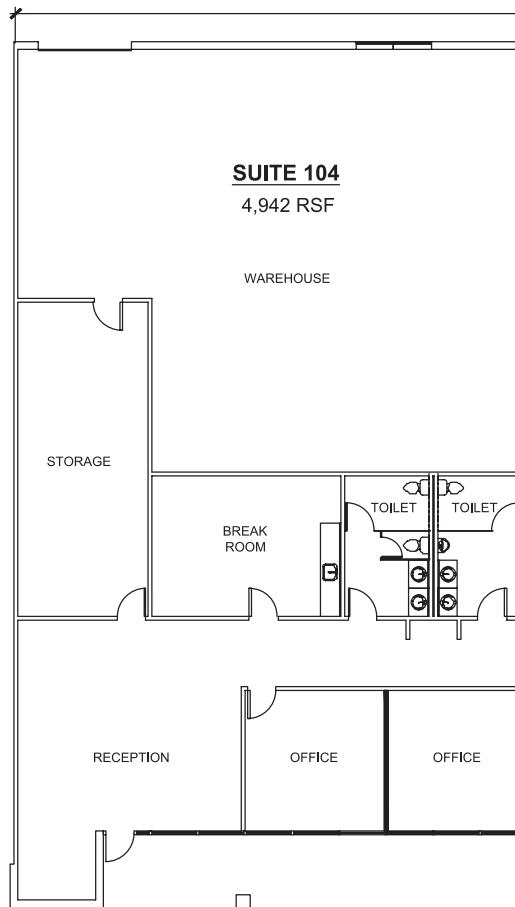

SITE PLAN

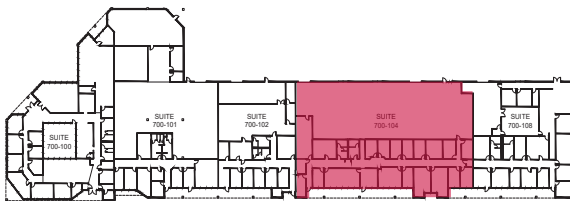

AERIAL

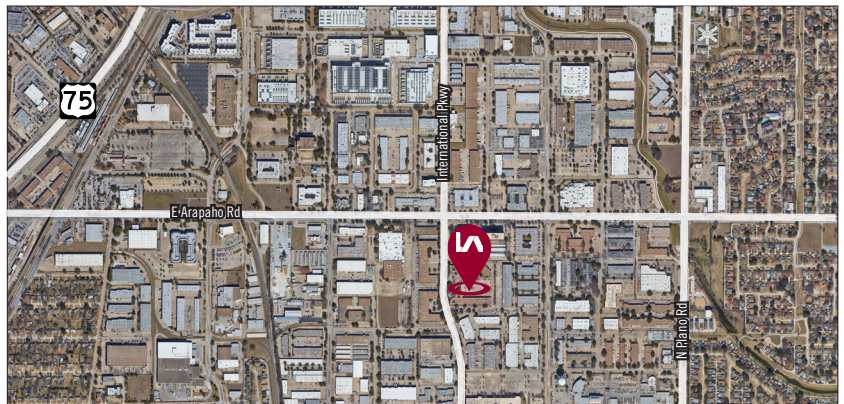

All information furnished regarding property for sale, rental or financing is from sources deemed reliable, but no warranty or representation is made to the accuracy thereof and same is submitted to errors, omissions, change of price, rental or other conditions prior to sale, lease or financing or withdrawal without notice. No liability of any kind is to be imposed on the broker herein.

FOR MORE INFORMATION:

JESSICA REINHARDT
972.934.4005
jreinhardt@lee-associates.com


SUSAN CANCEMI
972.934.4005
scancemi@lee-associates.com

MANAGED BY:




FLOOR PLAN | CONCEPTUAL DEMISING PLAN

STE 700-106
8,694 SF

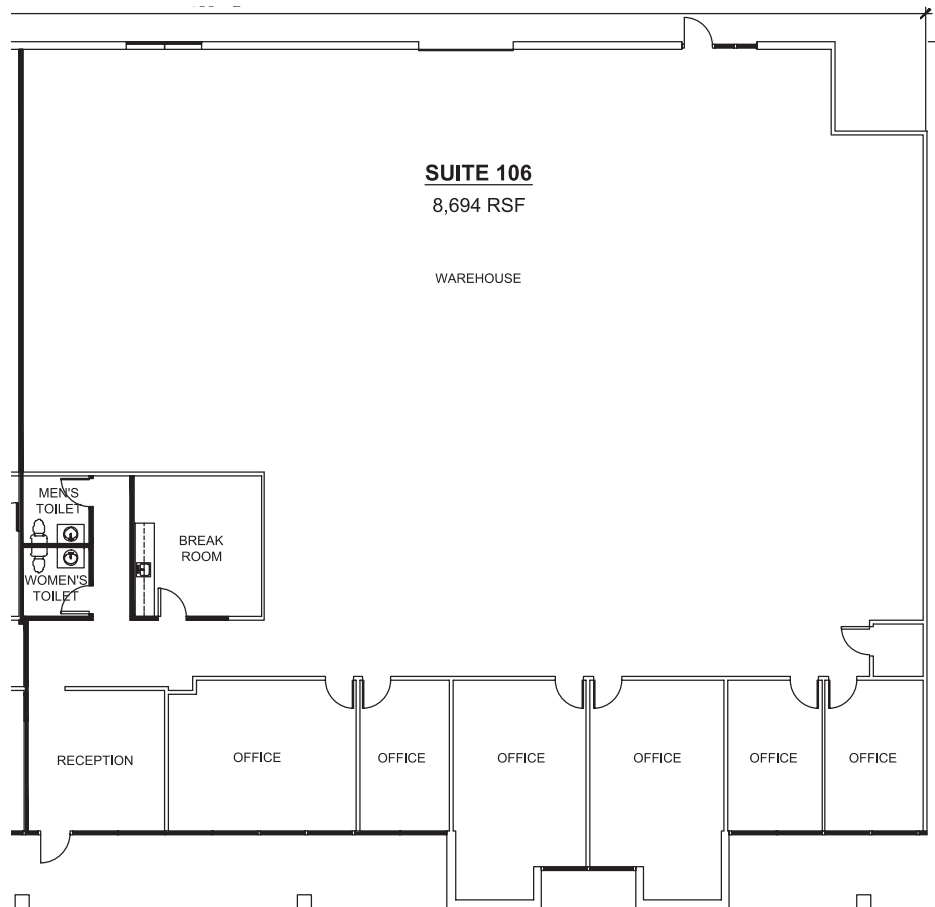

SITE PLAN

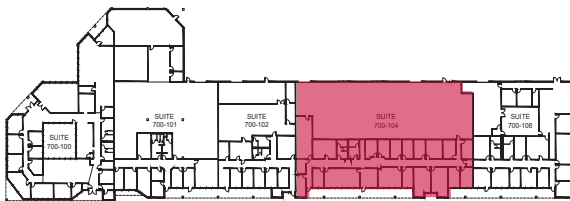

AERIAL



All information furnished regarding property for sale, rental or financing is from sources deemed reliable, but no warranty or representation is made to the accuracy thereof and same is submitted to errors, omissions, change of price, rental or other conditions prior to sale, lease or financing or withdrawal without notice. No liability of any kind is to be imposed on the broker herein.

FOR MORE INFORMATION:

JESSICA REINHARDT
972.934.4005
jreinhardt@lee-associates.com

SUSAN CANCEMI
972.934.4005
scancemi@lee-associates.com

MANAGED BY:

